FLOOR PLAN POWER, DATA, HVAC

- OUTLET - DUPLEX
- OUTLET - DUPLEX GFI
- OUTLET - DEDICATED SINGLE
- OUTLET - QUAD
- OUTLET - DUPLEX - FLOOR
- SWITCH - SINGLE
- SWITCH - DOUBLE PLATE
- SWITCH - TRIPLE PLATE
- SWITCH - DIMMER SINGLE
- SWITCH - DIMMER DOUBLE
- SWITCH - DIMMER TRIPLE
- SWITCH - JAMB
- ACCESS PANEL
- ALARM PANEL
- CONTROL PANEL - MISC.
- DOORBELL BUTTON
- ELECTRICAL BOX
- ELECTRIC METER
- ELECTRICAL PANEL
- ELEVATOR BUTTONS
- GAS METER
- INTERCOM
- JACK - CABLE
- JACK - DATA
- MISCELLANEOUS
- SHOWER HEAD
- TELEVISION
- THERMOSTAT
- WALL MOUNTED LIGHT
- WALL MOUNTED SPRINKLER HEAD

RCP POWER, DATA, HVAC
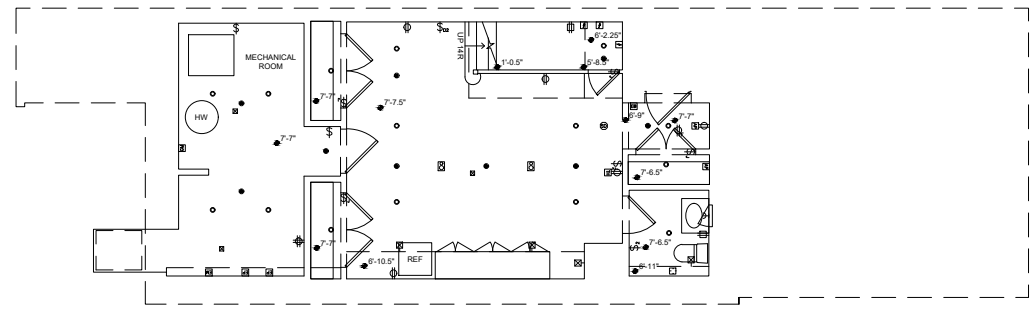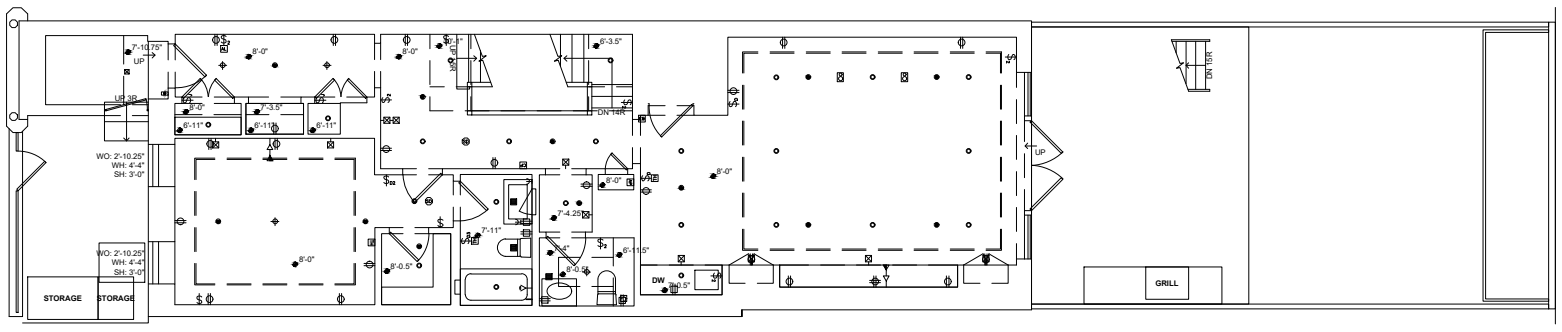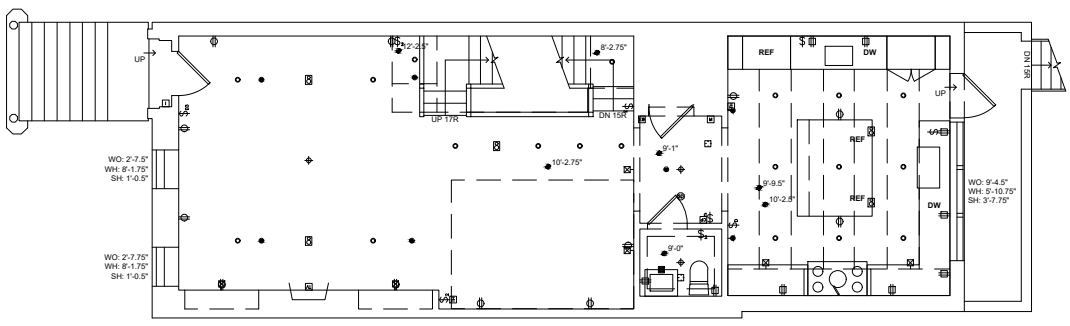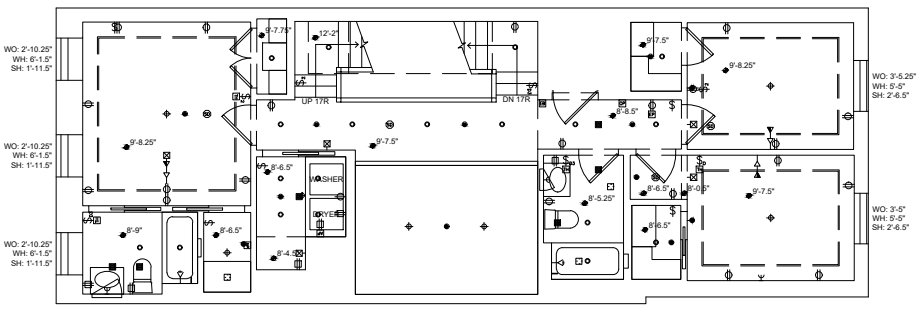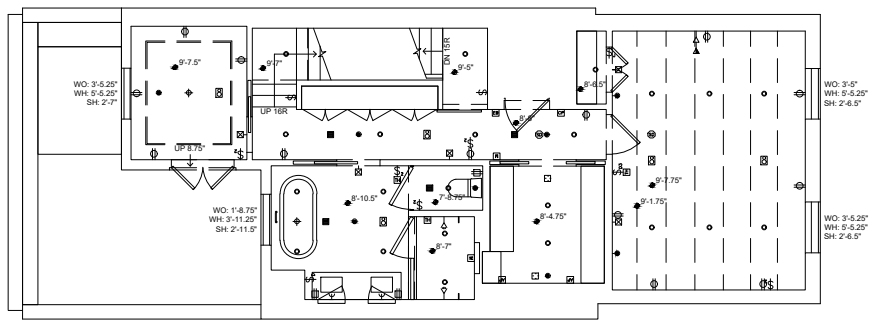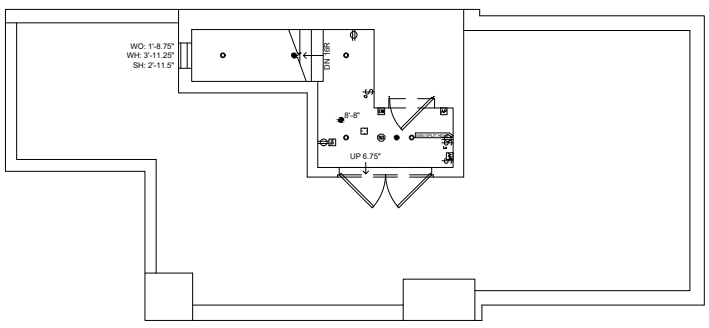
- CEILING RECESSED LIGHT
- CEILING SURFACE MOUNTED LIGHT
- CEILING SMOKE DETECTOR
- CEILING SPRINKLER HEAD
- CEILING VENT
- CEILING ACCESS PANEL
- CEILING SPEAKER